



Schenectady County  
Purchasing Department

620 State St.-2<sup>nd</sup> Floor  
Schenectady, NY 12305  
[Purchasing@schenectadycounty.com](mailto:Purchasing@schenectadycounty.com)  
518.388.4240

**ADDENDUM**

---

**RFB-2023-62**  
**RENOVATIONS TO: SCHENECTADY COUNTY COURTHOUSE RESTROOM**  
**C2 DESIGN GROUP**

**ADDENDUM #1**

Issued Date: 05/19/2023

The purpose of this addendum is to provide detailed information to all Bidders. This addendum is hereby included in and made part of the Contract Documents, whether or not attached thereto. Receipt of this Addendum must be acknowledged on the bid form.

**CONTENTS/RESPONSE TO QUESTIONS/REFERENCE TO ATTACHMENTS**

- **SK-01 Project Site location for Contractor's Dumpster & Staging Area**
- **SK-02 Project fire alarm communications path to main COB fire alarm panel**
- **#RFB-2023-62 Pre-bid Walk through Sign in Sheet (5/11/2023): Attended Contractor list.**

**General RFI's:**

1. Are work hours from 7:00am – 3:30pm?
  - a. Response: Yes, the contractor will be provided a FOB for access and can work their preferred hours.
2. Is there a possible location for dumpster on site?
  - a. Response: Yes, see SK-01
3. Are there security check-ins required for contractors daily?
  - a. Response: Security checks will not be required, but no tools or materials may be left unattended outside the bathroom in the public space. A lockable Jobox will be allowed to be kept in the public waiting area if needed.



Schenectady County  
Purchasing Department

620 State St.-2<sup>nd</sup> Floor  
Schenectady, NY 12305  
[Purchasing@schenectadycounty.com](mailto:Purchasing@schenectadycounty.com)  
518.388.4240


## ADDENDUM

---

4. There are mentions of multiple wall tile backer substrates on the drawings. Please specify which substrate is to be used on the walls behind the tile.
  - a. Response: Use 5/8" Certaineed "GlasRoc" Tile Backer (Type X) or Equal for all tile backer substrates as noted in the contract documents. Start backer board 2" below new top of tile start.
    - i. Exception: Detail 7/A900 – add note to use 1/2" "GlasRoc" Tile Backer board (Type X) over the layer of 5/8" GWB.
5. On detail 10 of drawing page A-100 there is reference to note "117" on the floor plan keynote legend, there is no 117 listed. Please clarify.
  - a. Response: On detail 10 of drawing A-100 change key note reference "117" to read key note reference "107".

**Please acknowledge this addendum on your bid form.**

**END OF ADDENDUM #1**

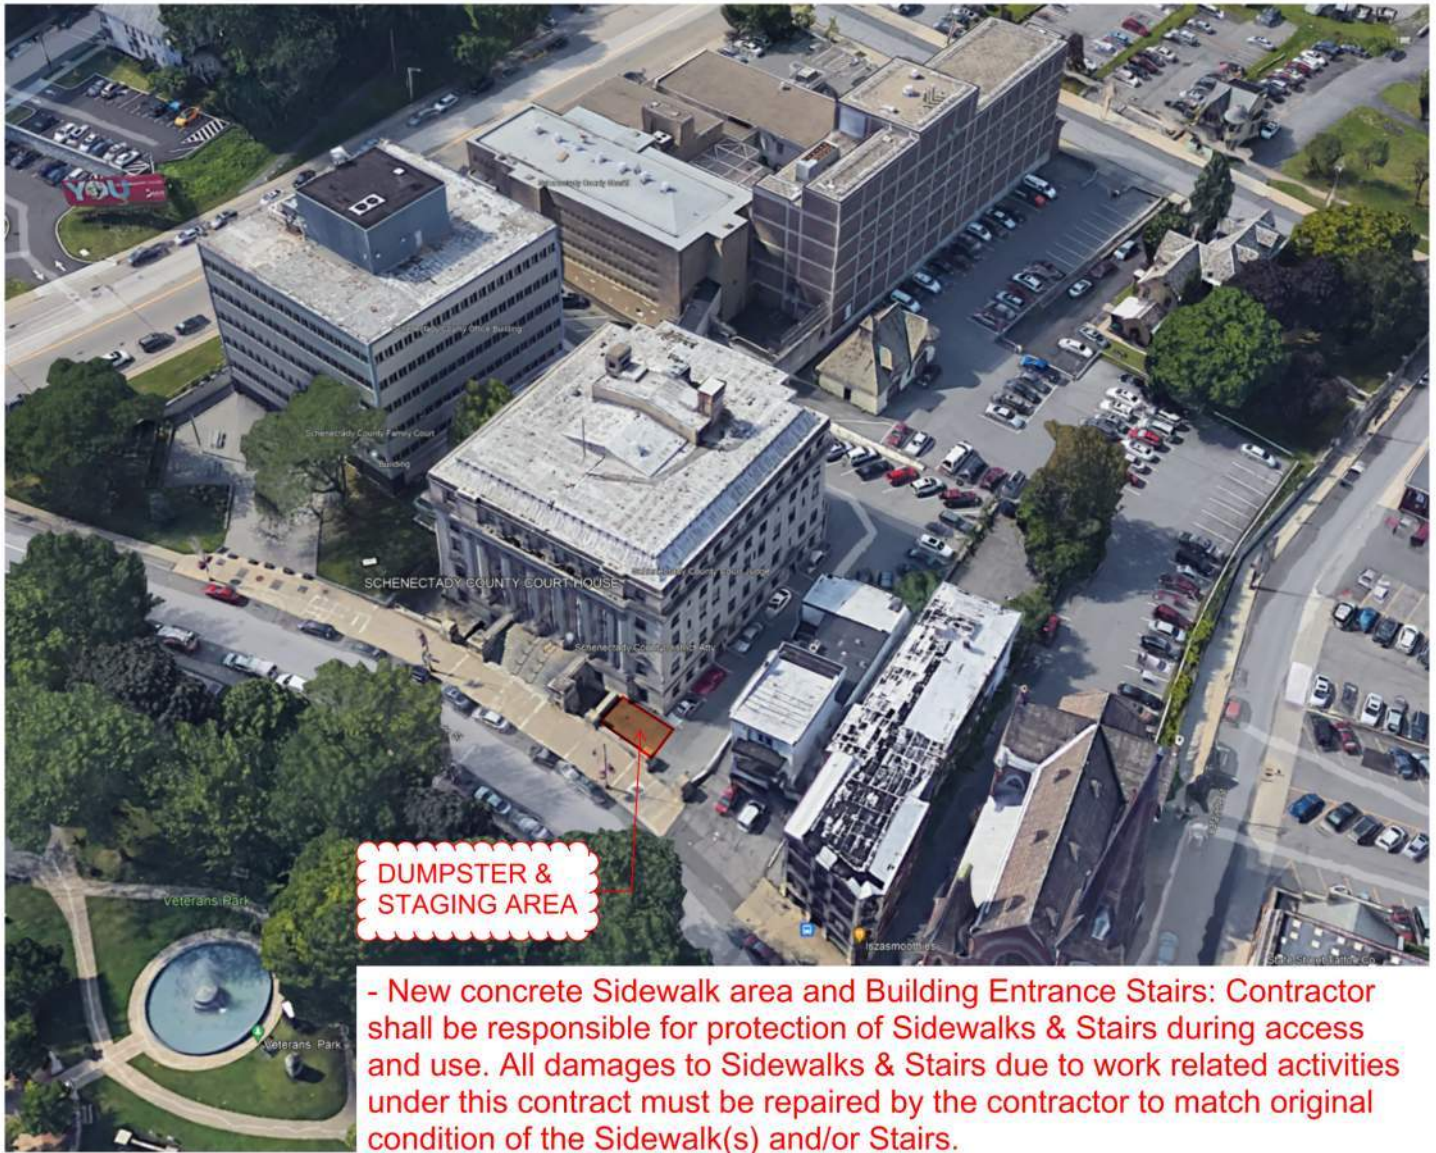

Schenectady County Courthouse  
 612 State Street, 1st Floor  
 Schenectady, NY 12305

DRAWN BY:	C2 Architecture
DATE:	04/26/2023
SCALE:	AS NOTED
JOB NO:	2257
SHEET:	<b>SK-01</b>


Project Site Location for Contractor's Dumpster & Staging Area	
PROJECT:	Renovations To: <b>Courthouse Restroom</b>
612 State Street, 1st Floor Schenectady, NY 12305	

Bid Documents - RFB-2023-62		
No.	SUBMITTAL / REVISION	DATE:
03	Addendum #1	05/19/2023

STAMP:
--------




PHOTO DATE: 5/16/2023 4:48:53 PM

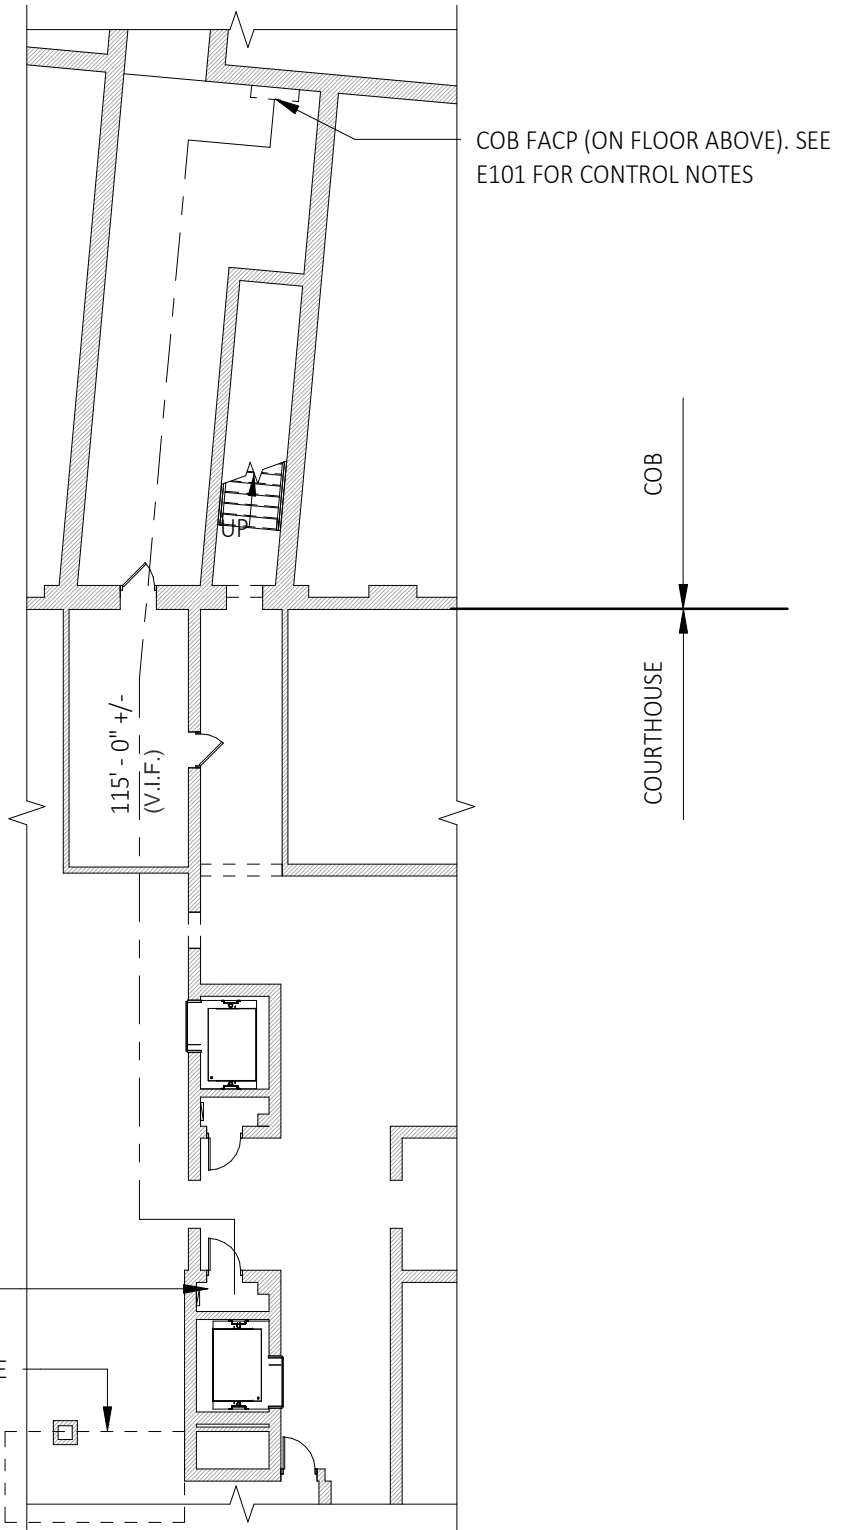

1  
SK-02

# Basement Plan

SCALE: NTS

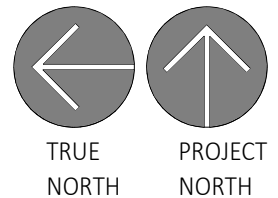

PLOT DATE: 5/16/2023 4:48:32 PM

DRAWN BY:	C2 Architecture
DATE:	04/26/2023
SCALE:	AS NOTED
JOB NO:	2257
SHEET:	<b>SK-02</b>

SHEET TITLE:	Fire Alarm Comm. Path to Main COB Panel
PROJECT:	Renovations To: <b>Courthouse Restroom</b>
612 State Street, 1st Floor Schenectady, NY 12305	

Bid Documents - RFB-2023-62		
No.	SUBMITTAL / REVISION	DATE:
01	Addendum #1	05/19/2023

STAMP:





